

INSPECTION TO BE PRINTED OR TYPED

Hampshire HEALTH DEPARTMENT ON-SITE SEWAGE DISPOSAL SYSTEM INSPECTION FORM

Permit No.: ST-14-06-289 Tax Map: 6 Parcel #: 27 County Road: Springfield Pike

County:

Name of Owner: Grover & Susan Loy Installer: Travis Kidwell Address: 241 McFarland Rd Winchester, VA 22602 Property Location: Shadow Knolls Lot 27 Upper entrance East Lot on Rt Type of Facility: SFD Facility is: New (X) Existing () Lot Size: 32 Sq. Ft. (Acres) Design Loading in gpd/No. Bedrooms: 3 Source of Water Supply: proposed well

SEWAGE TANK COMPONENT

Capacity in Gallons: 1000 Material: precast conc Manufacturer: Distances (in feet) of Tank to: Dwelling: 27 Private ()/Public () Water Source: Property Line:

ON-SITE DISPOSAL SYSTEM

Class I Systems: Standard Soil Absorption Trenches () or Bed () Gravelless Pipe (), Diameter: Inches Chamber Soil Absorption Trenches (X) or Bed () Class II Systems: Pumped/Dosed Soil Absorption Trenches () or Bed () Evapotranspiration Trenches () or Bed () Shallow Soil Absorption Trenches () or Bed () Other:

No. of Lines: 3 Length (in feet) of Each: 80, 85, 80 Width of Trenches: 36 inches/feet Depth to Bottom of Field: 24 inches If Bed, Dimensions (in Feet): If Chamber System, Name: No. of Units: Approved and Adequate Materials Used? Yes (X) No () Size Equates to: 1200 Square Feet of Standard Gravel Field. Distances (in feet) of System to: Dwelling: 57 Private ()/Public () Water Source: Property Line: 7100


Remarks:

An inspection indicates that the sewage disposal system described above DOES MEET (X) DOES NOT MEET (), CANNOT BE DETERMINED TO MEET () the minimum standards established by the West Virginia Bureau of Public Health.

To correct a health hazard, modifications to existing systems may be done to improve part of a system. Such modifications may not be able to be designated as a does meet system since inadequate information is known.

Although many factors contribute to the successful functioning of a sewage disposal system, this office recommends water conservation and maintaining an even usage of water throughout the week.

Sketch of Installation with Triangulation or Distance to Specific Landmarks:

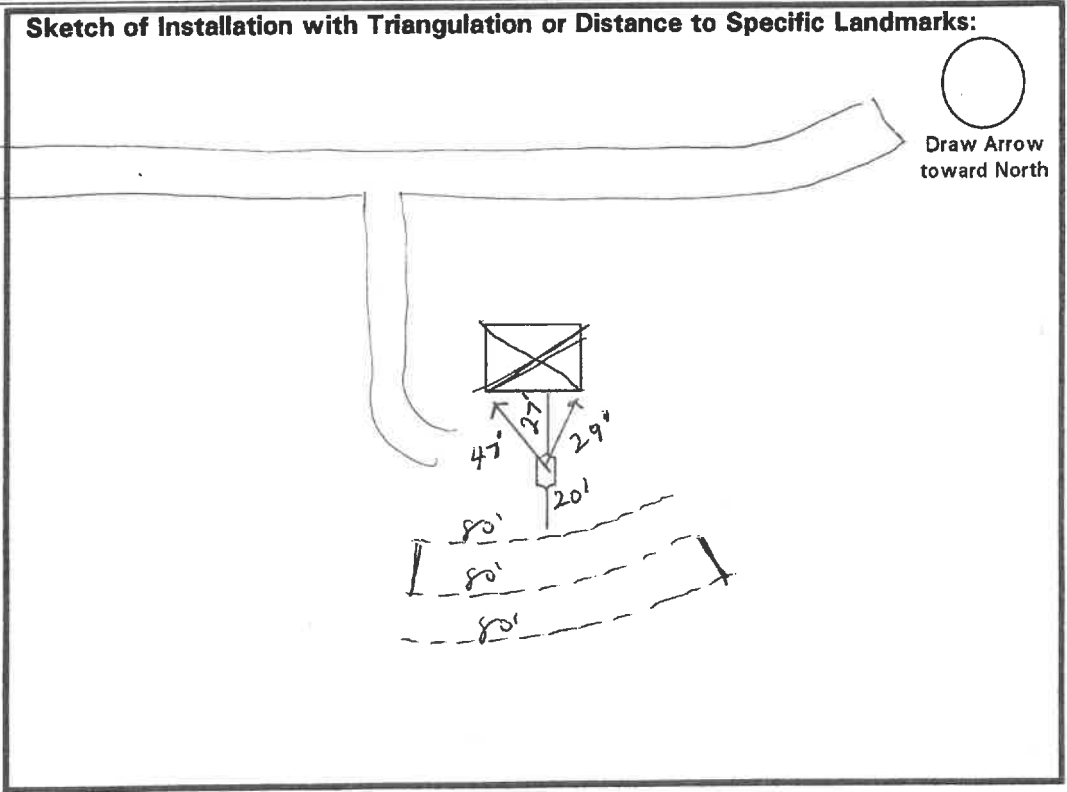

Visit Date(s):

Final Inspection Date: 11/2/06

Sanitarian: [Signature]