

Frame Drilling Company
PO Box 1907
Elkins, WV 26241
Tel: 304-636-6025
Fax: 304-636-0231

Well Completion Report

County Mary

Permit #DW 16-15-006

Well Owner Meredith Address _____

Well depth 711 Casing _____

Comments:

Depth in feet	Formations	Depth in feet	Formations
606-615	Red S.S. (hard)		
615-618	Red S.S. (med)		
618-621	Pale Red S.S. (very hard)		Casing app 2.5'
621-624	Lt. Gray S.S. (very hard)		Above grade. Some
624-626	Gray S.S. (syt)		backfill at well
626-641	Red S.S. (very hard)		site. will occur.
641-676	DK Red S.S. (very hard)		
676-679	Lt. Red S.S. (very hard)		
679-689	Red S.S. (med)		
689-705	Red S.S. (med)		
705-711	Red S.S. (hard)		
	H ₂ O nt		
257'	1/2 gpm		
321	1 gpm		
500 1/2	1 gpm		
604	2 1/2 gpm		
626	1 gpm		



U: N: 39°07.32.934

HARDY COUNTY Department of Health

Tax Map Name: _____

ong: W: 78°50'58.820

**ON-SITE SEWAGE DISPOSAL SYSTEM
INSPECTION REPORT**

Map # _____ Parcel # _____

Name of Owner: MIKE MEREDITH Installer: LARRY SCOTT

Owner Address: P.O. Box 1975 HARRISONBURG, VA 22803

Property Location: TOP OF MOUNTAIN SUBDIVISION LOT 17 MOOREFIELD

Subdivision: TOP OF MOUNTAIN Lot number: 17

Type of Facility: NEW HOME Facility is: New ☒ Existing ☐ Lot Size (ft² acres): 8.1

Design Loading: BEDROOMS: 3 or GPD: _____ Water Supply: Existing ☒ Proposed ☐ Type: WCI

System requires a perpetual maintenance program as per 64CSR9.7.2: Yes ☐ No ☐

SEWAGE TANK COMPONENTS

SEPTIC TANK	Septic Tank 1:	Septic Tank 2:	Pump Chamber:	SEPTIC TANK	Septic Tank 1:	Septic Tank 2:	Pump Chamber:
Capacity in Gallons:	<u>1000</u>			Distance to dwelling:	<u>NOT CONNECTED</u>		
Constructed of:	<u>CONCRETE</u>			Distance to water	Line:		
Manufacturer:	<u>PILES</u>			Source:			
4" inspection port, or riser to surface?	Riser ☒ Port ☐	Riser ☐ Port ☐	Riser ☐	Distance to property line:	<u>100'</u>		
				Effluent filter?	Yes ☐ No ☒	Yes ☐ No ☐	

ABSORPTION FIELD

Class I ☒ Chamber ☒ Eljen ☐ Gravelless Pipe ☐ Gravel Media Trenches ☐ Other _____
System:
Manufacturer: INFILTRATOR Square footage Permitted 900 ft² installed 900 ft²
Number of lines 3 Trench width 18-36 inches
Lengths of lines 60' 60' 60'

Inspection ports installed? Yes ☐ No ☒ Distribution box used? Yes ☒ No ☐ Outlets level? Yes ☒ No ☐

If chambers, length of each section: 4' Gravelless pipe diameter: _____

If bed configuration used, dimensions _____ x _____ Maximum depth to bed bottom on upslope side: _____

Distance of absorption field to Dwelling 40' Water Supply: 100' Water Line _____ Property Line _____

Drainfield laterals installed on-contour: Yes ☒ No ☐ Average Depth: 24 Maximum depth: 36

Class II System: Design type _____

marks: _____


System is installed as per the permitted design and layout. Yes ☒ No ☐
Include sketch of installation on reverse.

Sketch of installation with Triangulation or Distance to Specific Landmarks.

Include reserve area boundaries.

LEGEND:

	House/Facility		Property Line		Fence		Pump Tank
	Soil Absorption Line		Single Wide Manufactured Home		North		Septic Tank
	Existing Water Supply		Distribution Box		Stream Flow		
	Proposed Water Supply		Drain Field Inspection Port		Wooded Area Boundary		

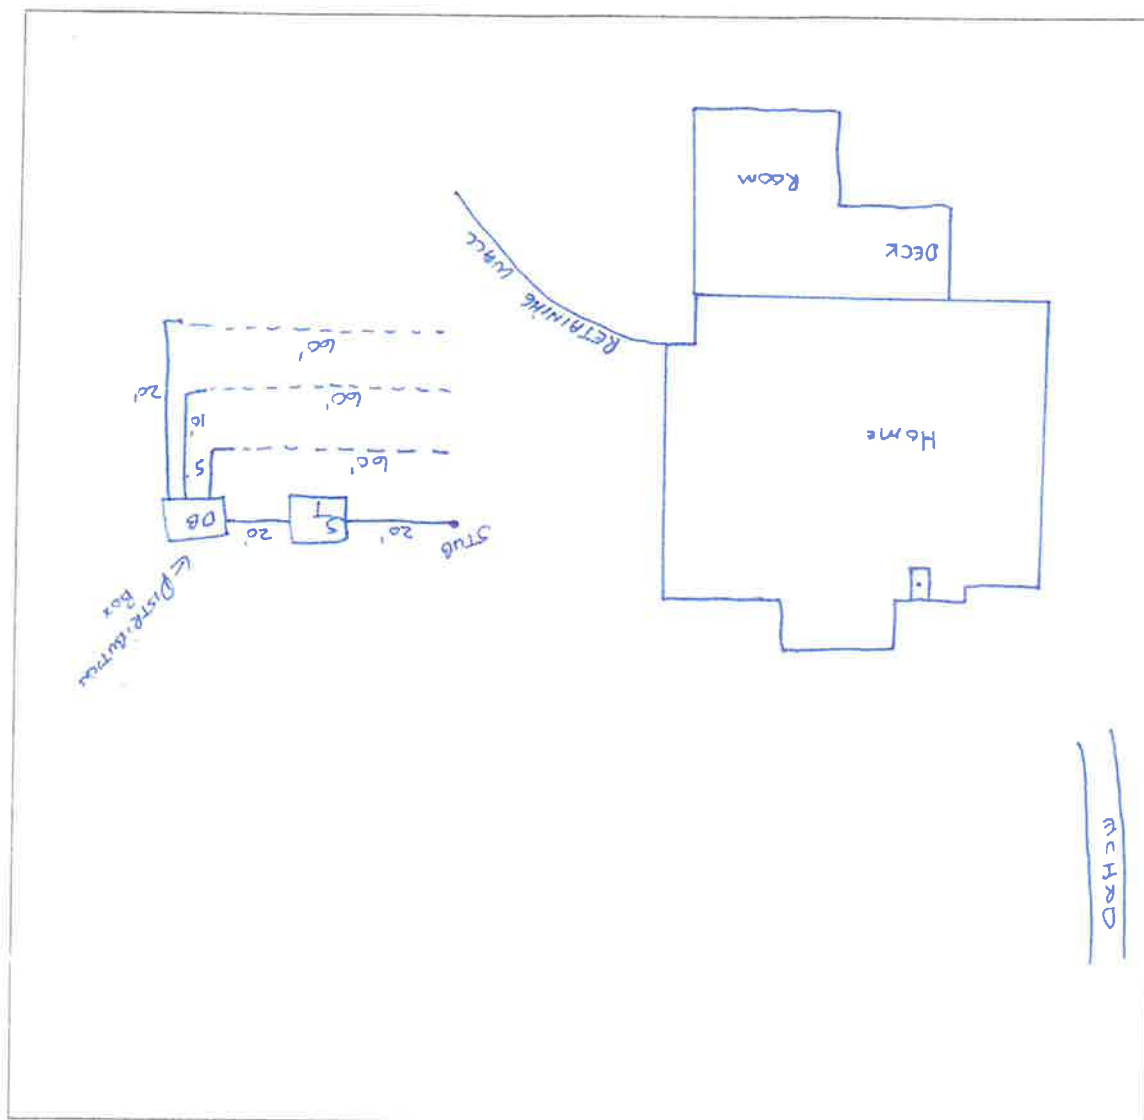

System is: Approved ☒ System is NOT Approved: ☐

COMMENTS:

Dates visited

William Ours
Sanitarian

7-27-15
Date Final Inspection